


3RD FLOOR #302



OVERALL ROOM DIMENSIONS ARE PRINTED TO REPRESENT GENERAL ROOM SIZES AND NOT FINISH DIMENSIONS. ALL FINISH CONDITIONS SHALL BE FIELD VERIFIED PRIOR TO CONSTRUCTION.

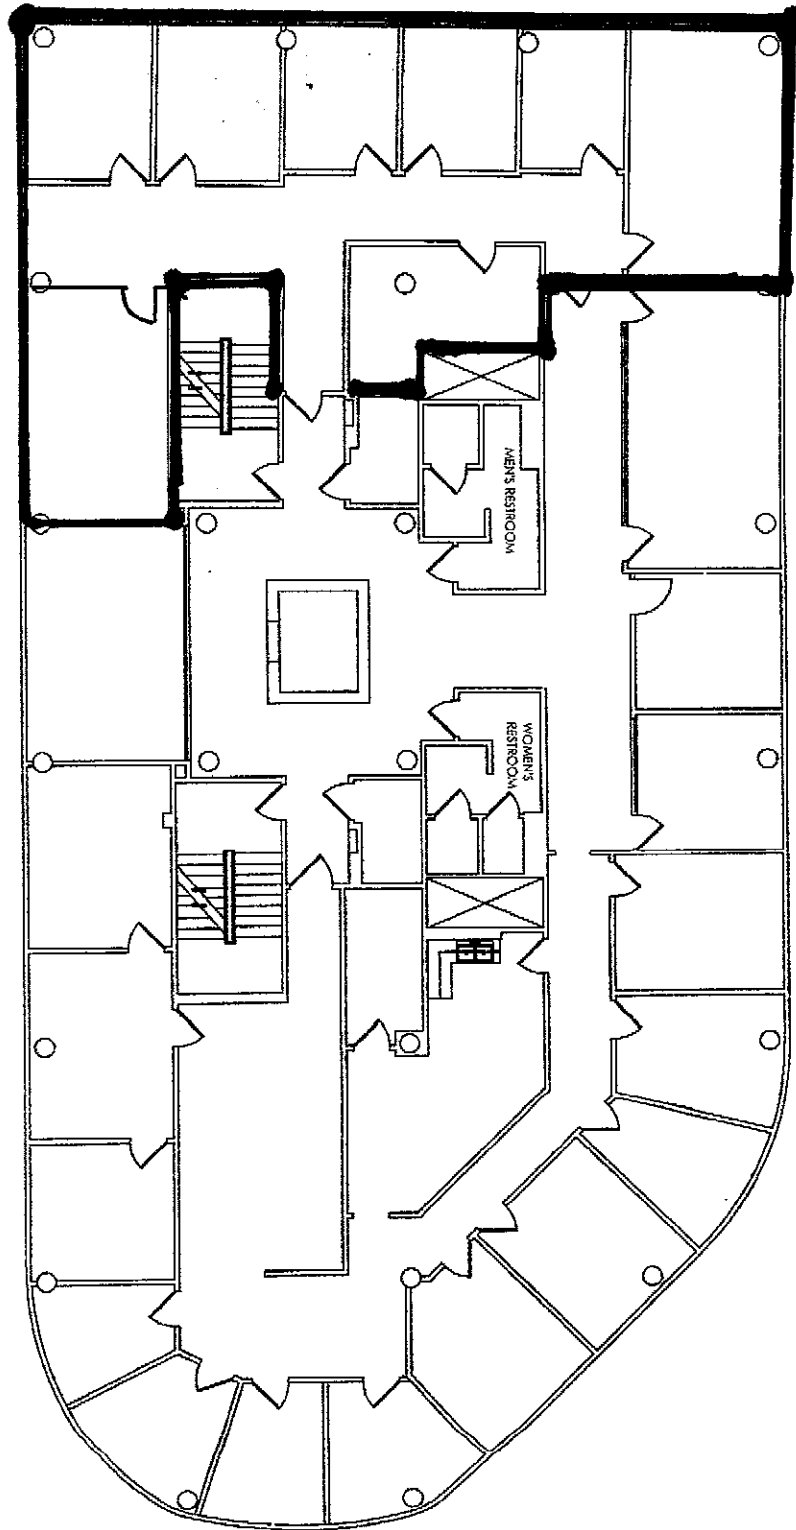

A-1

ASBUILT PLAN

DATE: 04/28/23

SCALE: 1/8" = 1'-0"

PROJECT: 04/28/23

REVISION: 12/1/23

THIRD FLOOR
880 CORPORATE DRIVE
LEXINGTON, KENTUCKY

Cathy Burgess Interiors

155 East Main Street Suite 102 Lexington, Kentucky 40507
858.255.5400 fx.859.280.9407

