




OVERALL ROOM DIMENSIONS ARE INTENDED TO REPRESENT GENERAL ROOM SIZES AND NOT FINISHING DIMENSIONS. ALL EXISTING CONDITIONS SHALL BE FIELD VERIFIED PRIOR TO CONSTRUCTION.

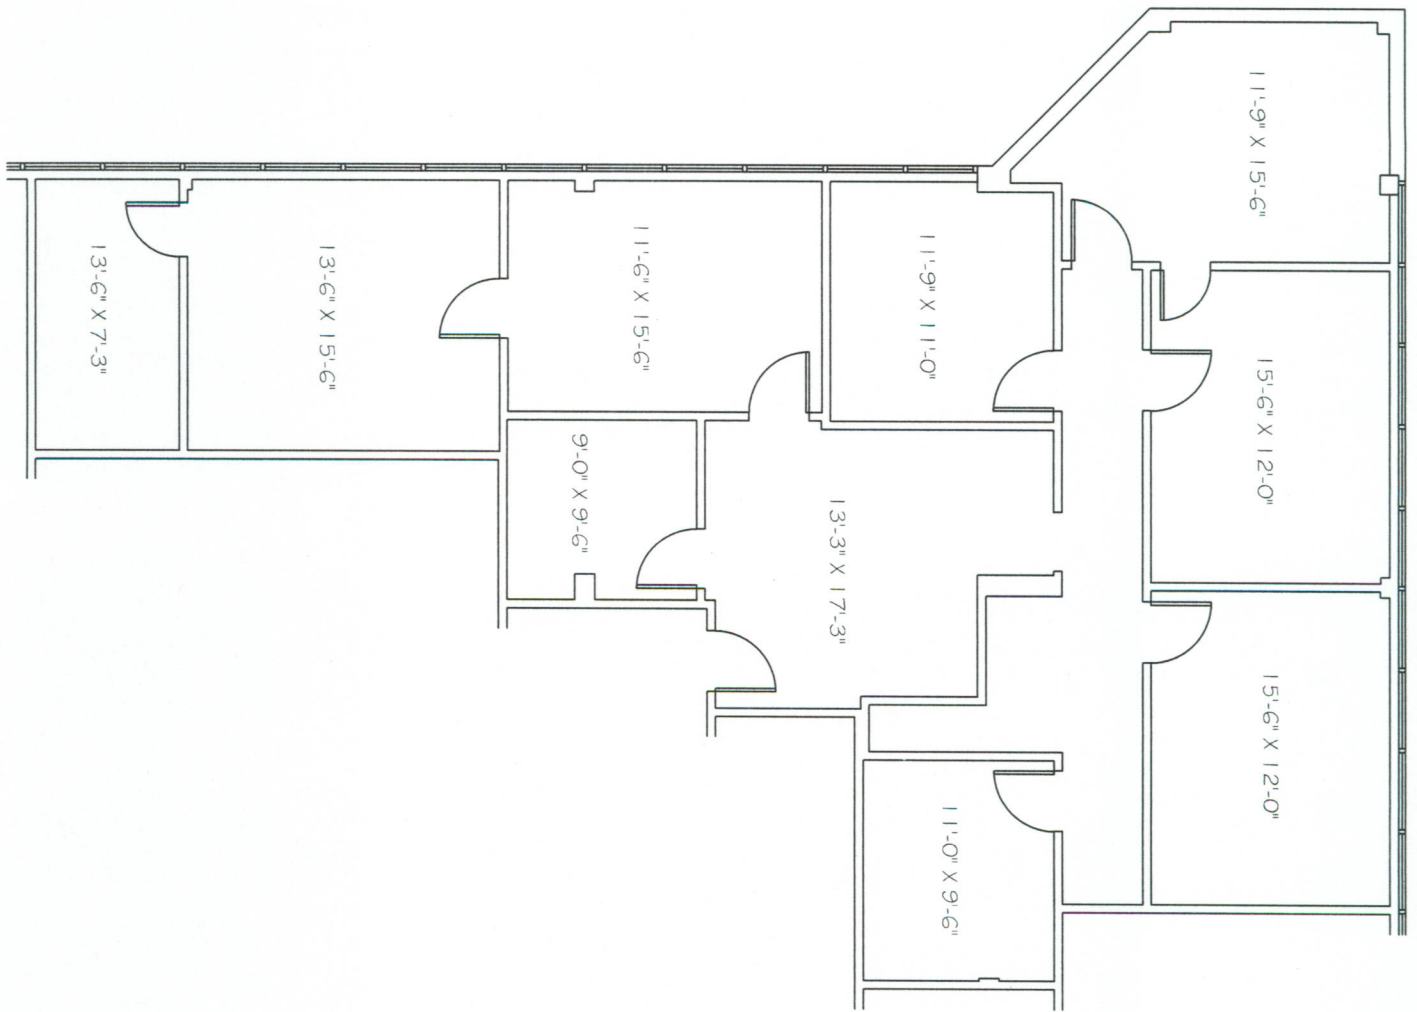

SUITE 200
870 CORPORATE DRIVE
LEXINGTON, KENTUCKY

Cathy Burgess Interiors

155 East Main Street Suite 102 Lexington, Kentucky 40507
859 255 9400 fx 859 255 9437



AS-BUILT PLAN

A-1

DATE	09.30.16
SCALE	NTS
DRAWN BY	DLS
REVISION	