


3RD FLOOR - ASBUILT PLAN

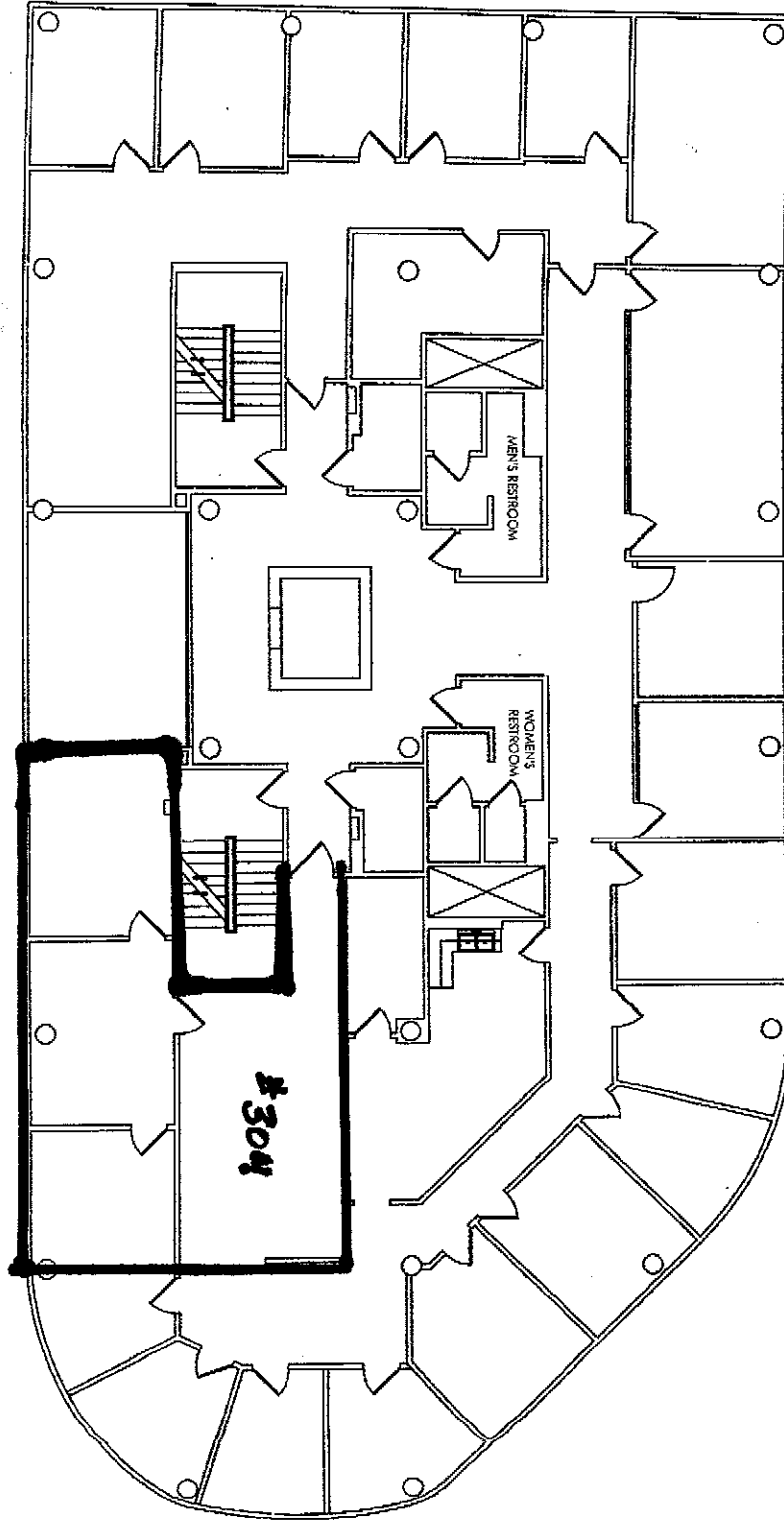

OVERALL ROOM DIMENSIONS ARE INDICATED TO REFLECT GENERAL ROOM SIZES AND NOT FINISH DIMENSIONS. ALL FINISH CONDITIONS SHALL BE FIELD VERIFIED PRIOR TO CONSTRUCTION.



A-1

ASBUILT PLAN

SHEET: 03.08.21
 DATE: 11.11.21
 DRAWN: JMB
 CHECKED: JMB
 PROJECT: 1211121

THIRD FLOOR
 880 CORPORATE DRIVE
 LEXINGTON, KENTUCKY

Cathy Burgess Interiors

155 East Main Street Suite 102 Lexington, Kentucky 40507
 606 255 9400 fx 659 256 9437

