


4TH FLOOR - ASBUILT PLAN

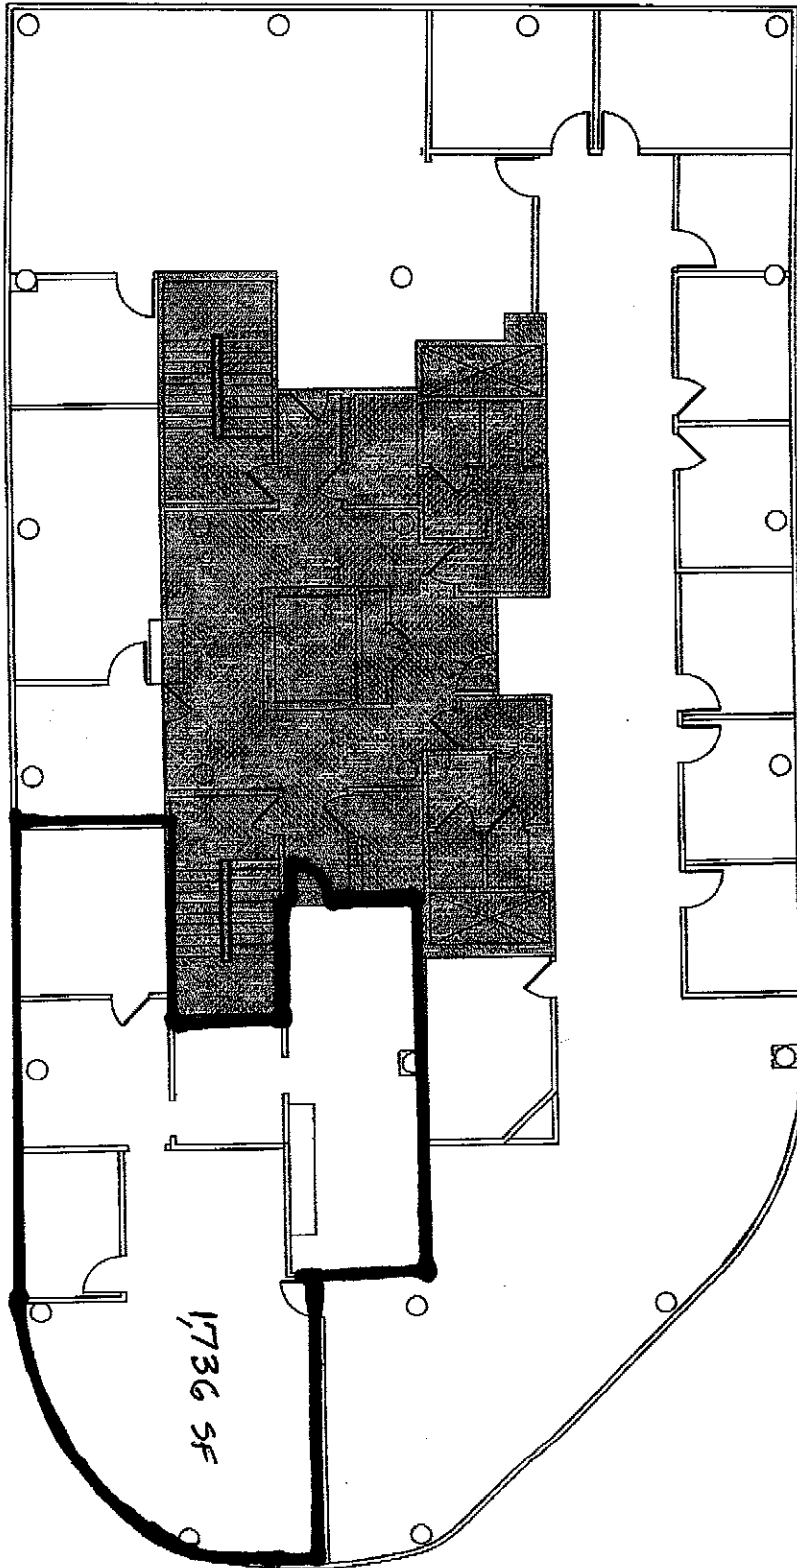

OVERALL ROOM DIMENSIONS ARE INTENDED TO REPRESENT GENERAL ROOM SIZES AND NOT FINAL TO BE DETERMINED BY FIELD MEASUREMENTS. DIMENSIONS SHALL BE FIELD VERIFIED PRIOR TO CONSTRUCTION.



A-1

ASBUILT PLAN

DATE: 03.25.21  
 FILE: A-1  
 DRAWN BY: JMB  
 CHECKED BY: JMB  
 APPROVED BY: JMB  
 12.11.23

FOURTH FLOOR  
 880 CORPORATE DRIVE  
 LEXINGTON, KENTUCKY

**Cathy Burgess Interiors**

155 East Main Street Suite 102 Lexington, Kentucky 40507  
 606 250 9100 or 606 253 9437

